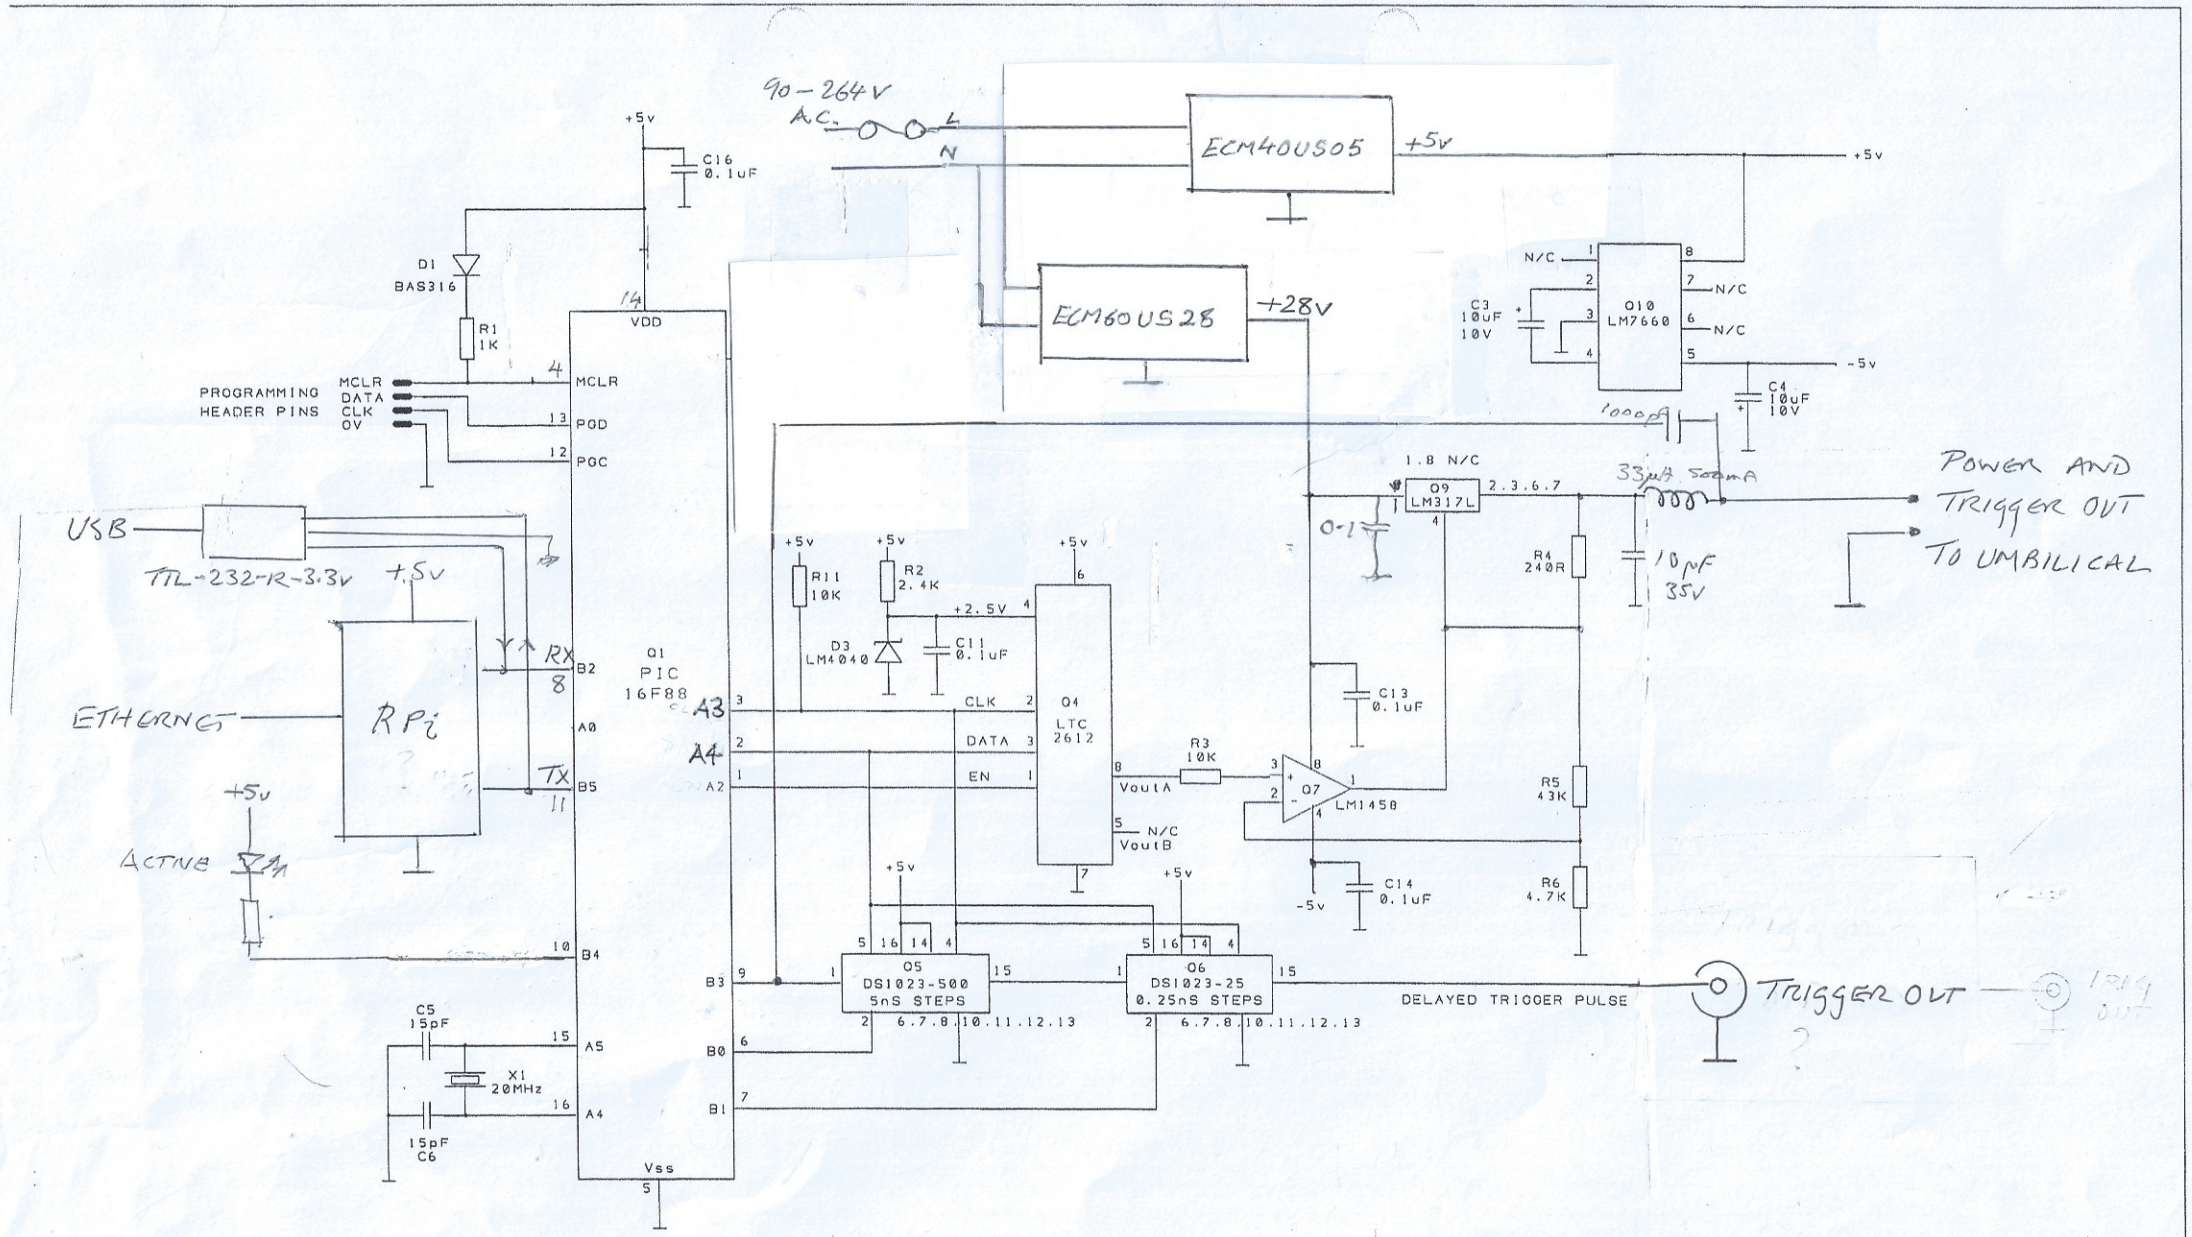

				UFO DRIVER		Richard White University of Sussex ~~28/06/2018~~
				Project NANO	Unit Prototype	
				Title ~~NANO_Module~~	Filename ~~NANOmulti.sch~~	Drawing No. 4/2/20 003